

DACW-33-85-D-0011 Delivery Order 0007  
Land Seismic, Westfield River  
Westfield, MA

FILE COPY

# ATLANTIC TESTING LABORATORIES, LIMITED

Sustaining Member—N.Y.S. Society of Professional Engineers

at

Box 29  
Canton, N.Y. 13617  
(315) 386-4578

Box 356  
Cicero, N.Y. 13039  
(315) 699-5281

December 20, 1985

U. S. Army Corps of Engineers  
New England Division  
424 Trapelo Road  
Waltham, MA 02254-9149

Attn: Mr. Richard Reardon

Re: Land Seismic, Westfield River  
Westfield, MA  
Contract DACW-33-85-D-0011  
Delivery Order No. 0007


Gentlemen:

In accordance with Delivery Order No. 0007, dated 16 October 1985, attached is one copy of our seismic investigation report for the Westfield River, Westfield, MA.

By copy of this letter, we are also transmitting two copies of this report to Mr. John Hart.

If you have any questions or comments, please do not hesitate to contact our office.


Respectfully submitted,

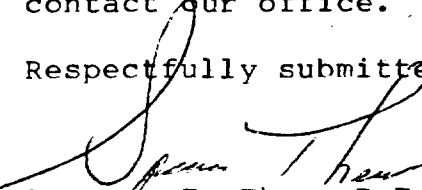  
Spencer F. Thew, P.E./L.S.  
President

SFT/smf

cc: Mr. John Hart (2)

encs.

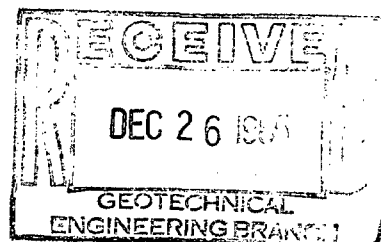

**SECTION 1**

**CONTRACT DACW-33-D-85-D-0011**

**CONTRACTING OFFICER:**

**Edward D. Hammond, LTC, CE**

**28 June 85**

**WORK ORDER NO. 0007**

**16 October 85**

**SEISMIC INVESTIGATION**

**WESTFIELD RIVER**

**WESTFIELD, MA**

**PREPARED FOR: U.S. Army Corps of Engineers  
New England Division  
424 Trapelo Road  
Waltham, MA 02254-9149**

**PREPARED BY: Theresa A. Beddoe, Hydrogeologist  
Atlantic Testing Laboratories, Limited  
P. O. Box 29  
Canton, NY 13617**

**November 26, 1985**

**ATL Report No. CD007-1-11-85**

## SECTION 2

### TABLE OF CONTENTS

SECTION 1	Title Page
SECTION 2	Table of Contents
SECTION 3	Scope of Investigation
SECTION 4	Quality Control/Assurance a. General Statement b. Quality Assurance Certification
SECTION 5	Summary of Activities
SECTION 6	Safety Reports
SECTION 7	Survey Field Notes
SECTION 8	Seismic Refraction Survey Report

### **SECTION 3**

#### **SCOPE OF INVESTIGATION**

Survey and exploration instructions, which were provided by the Army Corps of Engineers, New England Division, follow. The subsurface investigation program included about 4,200 feet of seismic survey lines required to determine depths to bedrock along a proposed dam alignment.

Work under this delivery order consisted of locating three seismic lines which traversed the Westfield River Valley and three lines perpendicular to these. Horizontal and vertical surveying techniques were used to determine locations and elevations of points along the seismic lines and of various site features.

SCOPE OF WORK

GEB REQUISITION NO. 86-3-DACW 33-85-D-0011

DELIVERY ORDER NO. 0007

SURVEY AND EXPLORATION INSTRUCTIONS

PROJECT: Seismic Investigation for Westfield River Basin Study

SITE: Westfield River, Westfield, Massachusetts

PURPOSE: Seismic surveys are required to determine depths to bedrock along a proposed dam alignment.

1. SCOPE OF INVESTIGATION.

a. Seismic survey lines shall be performed for a total of about 4,200 feet as shown on Attachment No. 2.

b. Surveys shall be done to determine locations and elevations compatible with site features shown on the enlarged USGS quadrangle Attachment No. 3.

2. SITE CONDITIONS.

The proposed seismic line traverses the Westfield River valley as shown on Attachment No. 2. The majority of the land in the area of interest is relatively flat at about elevation 150 feet and rises at the abutments to about elevation 250 feet. Sands and gravels are anticipated which may exceed 100 feet in thickness.

3. RIGHTS OF ENTRY.

The Contractor is responsible for securing any rights of entry, approvals, permits, etc. necessary for the performance of the work.

4. COORDINATION.

Mr. James Blair, Corps of Engineers, 617-647-8396, shall be contacted five days prior to start of work and each work day to report on how work is progressing and approximate depth to bedrock is being encountered.

5. EXPLORATION NUMBERS.

The seismic lines accomplished shall be numbered sequentially in order of their completion. The numbers shall be shown on the plan of completed explorations.

6. GOVERNMENT REVIEW.

The Government will review the draft submittal as well as the completed work. Subsequent to such review, the Contractor shall accomplish any corrections which may be directed as the result of the Government review.


## 7. COMPLETION SCHEDULE

Services under this delivery order shall start no later than 23 October 1985. Duration of field work is estimated to be three work days. The geotechnical report shall be submitted in draft format for review by the Government, postmarked no later than seven calendar days after completion of the field work. Government review will take approximately ten calendar days from receipt of draft report. The final geotechnical report shall be submitted postmarked no later than seven calendar days after receipt of draft report including the action taken on possible comments.

## 8. QUALITY CONTROL

You will be held responsible for the quality of the text and plates submitted and for all damages caused the Government as a result of your negligence in the performance of any services furnished under the contract.

Although submissions required by your contract are technically reviewed by the Government, it is emphasized that your work must be prosecuted using proper internal controls and review procedures. The letter of transmittal for each submission which you make shall include a certification that the submission has been subjected to your own review and coordination that the submission has been subjected to your own review and coordination procedures to insure (a) completeness for each discipline commensurate with the level effort required for that submission, (b) elimination of conflicts, errors and omissions, and (c) the overall professional and technical accuracy of the submission. Documents which are significantly deficient in any of these areas will be returned to you for correction and/ or upgrading prior to our completing our review. Contract submission dates will not be extended if a resubmission of draft material is required for this reason.

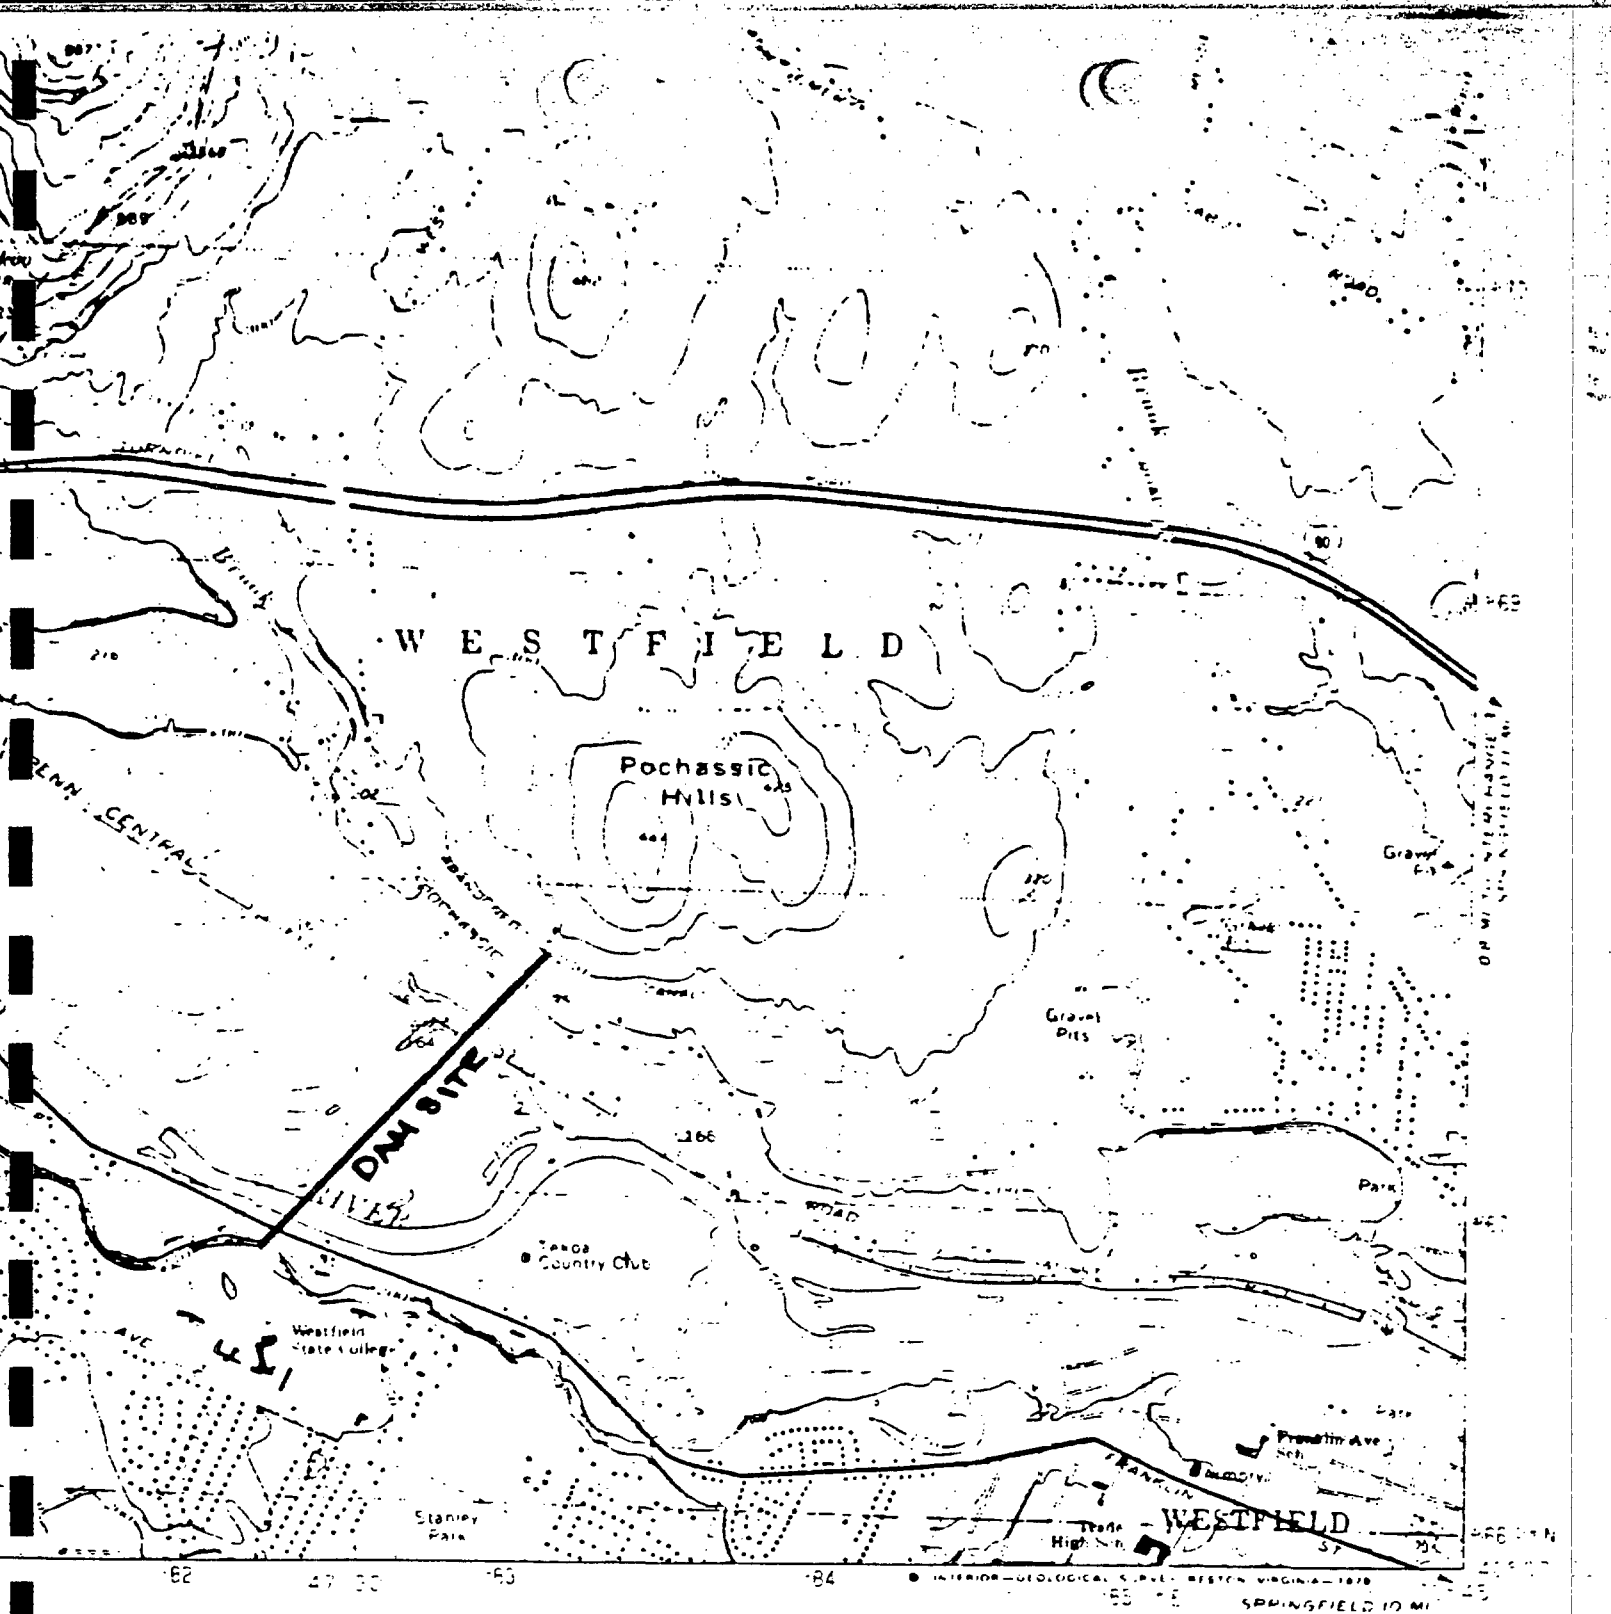

#### ROAD CLASSIFICATION

Primary highway, all weather hard surface	Light duty road, all weather, improved surface
Secondary highway, all weather hard surface	Unimproved road, fair or dry weather
Interstate Route	U S Route
	State Route

QUADRANGLE LOCATION


WORONOCO, MASS.

N4207.5—W7245.7.5

1967

AMS 446R III NE—SERIES VB14



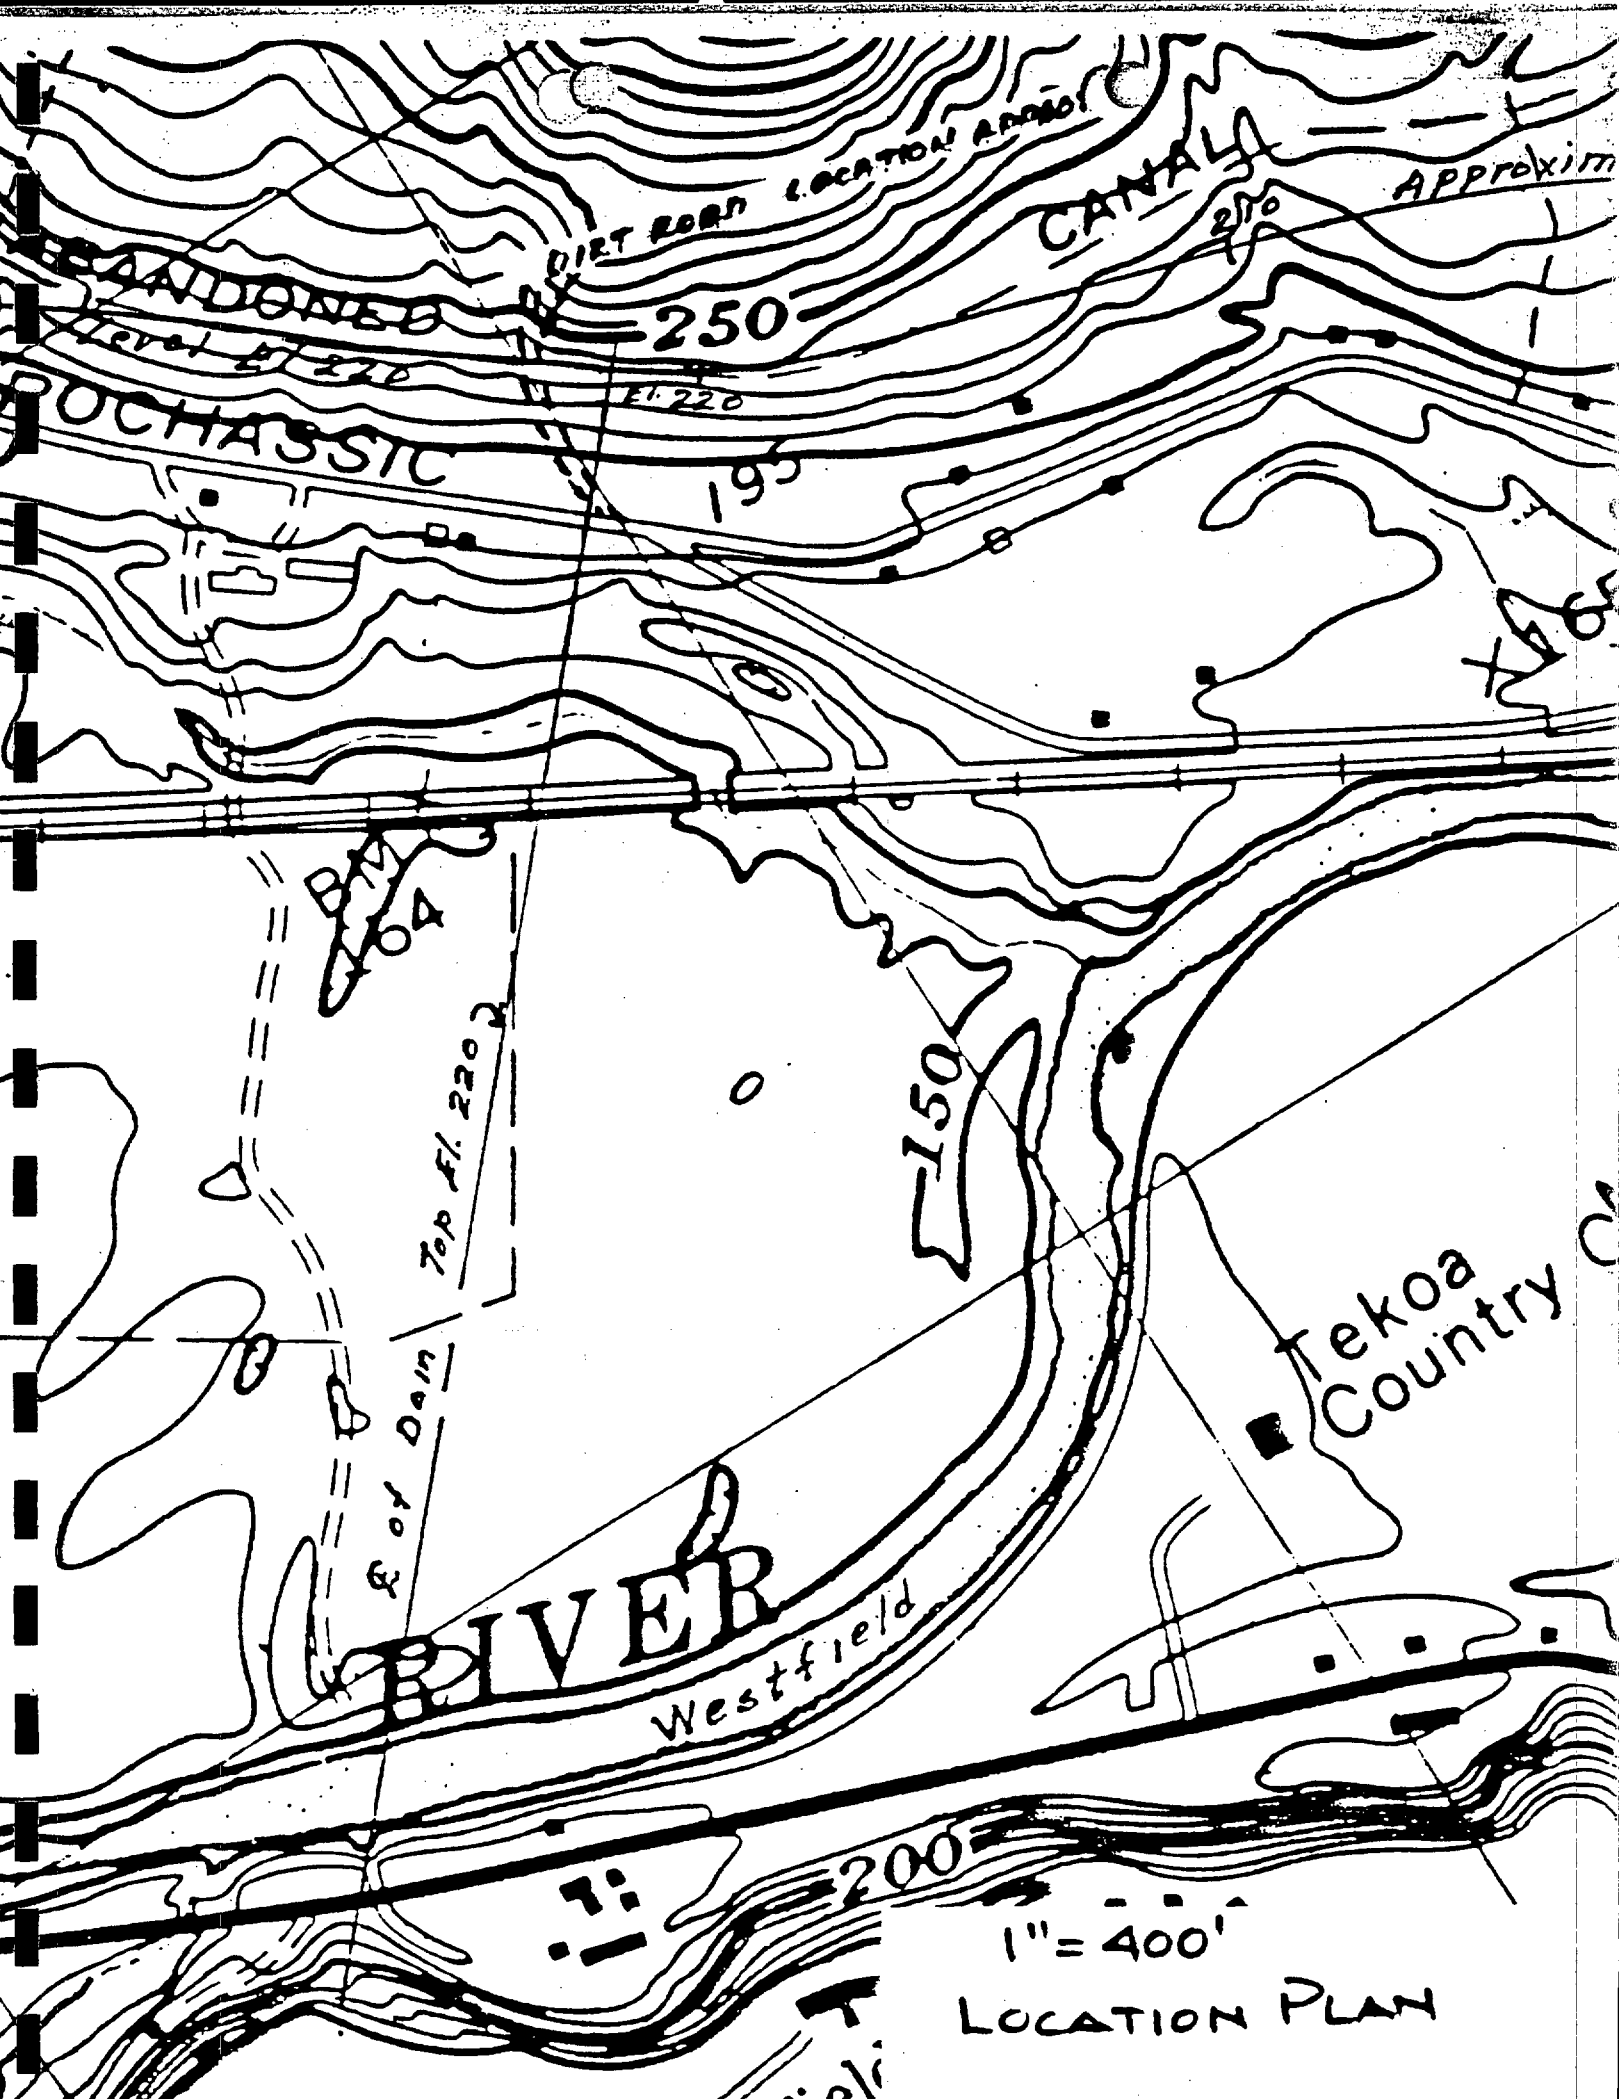

## SECTION 4

### QUALITY CONTROL/ASSURANCE

#### a. General Statement:


The equipment and procedures used to perform the work and the investigation results are summarized in the report prepared by Weston Geophysical Corporation, which is included as Section 8 of this report.

#### b. Quality Assurance Certification:

I hereby certify that the referenced records, equipment and procedures were used to perform the subsurface exploration described herein. I also certify that the work was performed in a professional manner and meets the requirements set forth in the work order.

CERTIFIED

26 November 1985

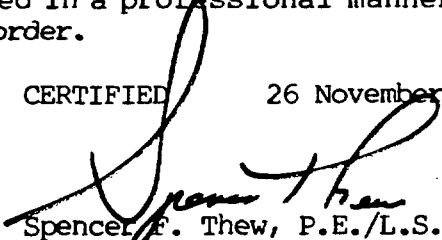  
Spencer F. Thew, P.E./L.S.

## SECTION 5

### SUMMARY OF ACTIVITIES

<u>Date</u>	<u>Activity</u>
11 Nov	Monday: Surveyors mobilized to the site
12 Nov	Tuesday: time on site 8:00 - 14:30 - Surveyors cleared property for right of access to private land on the west and east sides of the Westfield River - recon job for horizontal control - intermittent rain, rained out at 14:30
13 Nov	Wednesday: time on site 09:00 - 17:00 - Surveyors made arrangements for topographic enlargement at New England Blueprint Company in Springfield - gas company clears job, expect no problem with gas lines - Weston Geophysical obtained blasting permit - conduct safety meeting - Surveyors set up survey baseline and closed traverse - Seismic crew began seismic survey, 5 test holes completed for 800 feet
14 Nov	Thursday: time on site 08:00-16:00 - Surveyors finish horizontal control and level circuits - Seismic survey crew completed 1600 feet
15 Nov	Friday: time on site 09:00 - 17:00 - Surveyors obtain topographic enlargement at New England Blueprint Company in Springfield - Seismic survey completed (1600 feet) - alleged landowner on northwest side of road, Ms. Mary Priest, irate because of our presence on land whose access had previously been cleared with farmer on other side of road, Mr. Stevenson, who claimed ownership of the property on 12 November 85.

**SECTION 6**

**SAFETY REPORT**

# WEEKLY SAFETY MEETING

NEDSO

Date held 11/12/85

THRU: Area Engineer, \_\_\_\_\_ Area

Time 10:00 am - 12:00 am

TO: Safety Office, NED

1. Weekly safety meeting was held this date for the following personnel:

Contract No. CD 007 Contractor Atlantic Testing Labs

Conducted By Dana Drake All personnel present (Contr) Mark Blackuy & Olaf Wastha  
(Sub) Ed Aiken  
(Govt) \_\_\_\_\_

Subjects discussed (Note, delete, or add):  
EM 385-1-1, Section: \_\_\_\_\_

## NA Accident Prevention Plan

Individual Protective Equipment - ✓

Prevention of Falls - ✓

Back Injury, Safe Lifting Techniques - ✓

Fire Prevention - ✓

Sanitation, First Aid, Waste Disposal - ✓

Tripping Hazards - trash, hose, nails in lumber - ✓

NA Staging, Ladders, Concrete Forms, Safety Nets -

NA Hand Tools, Portable Power Tools, Woodworking Machinery -

NA Equipment Inspection & Maintenance (Zero Defects) -

NA Hoisting Equipment -

NA Ropes, Hooks, Chains and Slings -

Electrical Grounding, Temporary Wiring, GFCI - ✓

NA Lockouts for safe clearance procedures - electrical, pressure, moving parts -

NA Welding, Cutting -

NA Excavations -

Loose Rock and Steep Slopes - ✓

Explosives - ✓

NA Water Safety -

NA Toxic materials - hazards, MSDS, respiratory, ventilation -

Other - None

Prepared by Dana Drake Title L.S.

2. Forwarded. Exposure hours:

ATL 61.0

Weston 53.0

Geophys

Total 114.0

man hours  
on site

Signature \_\_\_\_\_  
Resident Engineer

**SECTION 7**

**SURVEY FIELD NOTES**

K- EA

W- DLD

Nov. 12-15, 1985

DIETZEN NO. 384-C

Westfield Seismic Survey  
Westfield, Mass.


Control pg. 1, 2

Stadia location pg. 2-6

Level circuit pg. 7, 8

STA	H &	H.I.	V &	d	Elev.
	Brng?				
	AZ: 5 → 4: 75°00'				
5-1-2	$15^{\circ}32'55''$ $31^{\circ}04'57''$ $05'00''$	$89^{\circ}22'12''$ $2966.34'$ $35'$			
4-5-1	$148^{\circ}40'48''$ $297^{\circ}21'36''$ $89^{\circ}40'$	$89^{\circ}46'12''$ $1383.88'$			
3-4-5	$229^{\circ}19'42''$ $98^{\circ}29'33''$	$90^{\circ}38'12''$ $900.85'$			
2-3-4	$66^{\circ}23'09''$ $132^{\circ}46'10''$	$92^{\circ}25'42''$ $801.08'$			
1-2-3	$80^{\circ}09'12''$ $160^{\circ}18'30''$	$89^{\circ}49'42''$ $575.56'$			


MEZGER NO. 3846

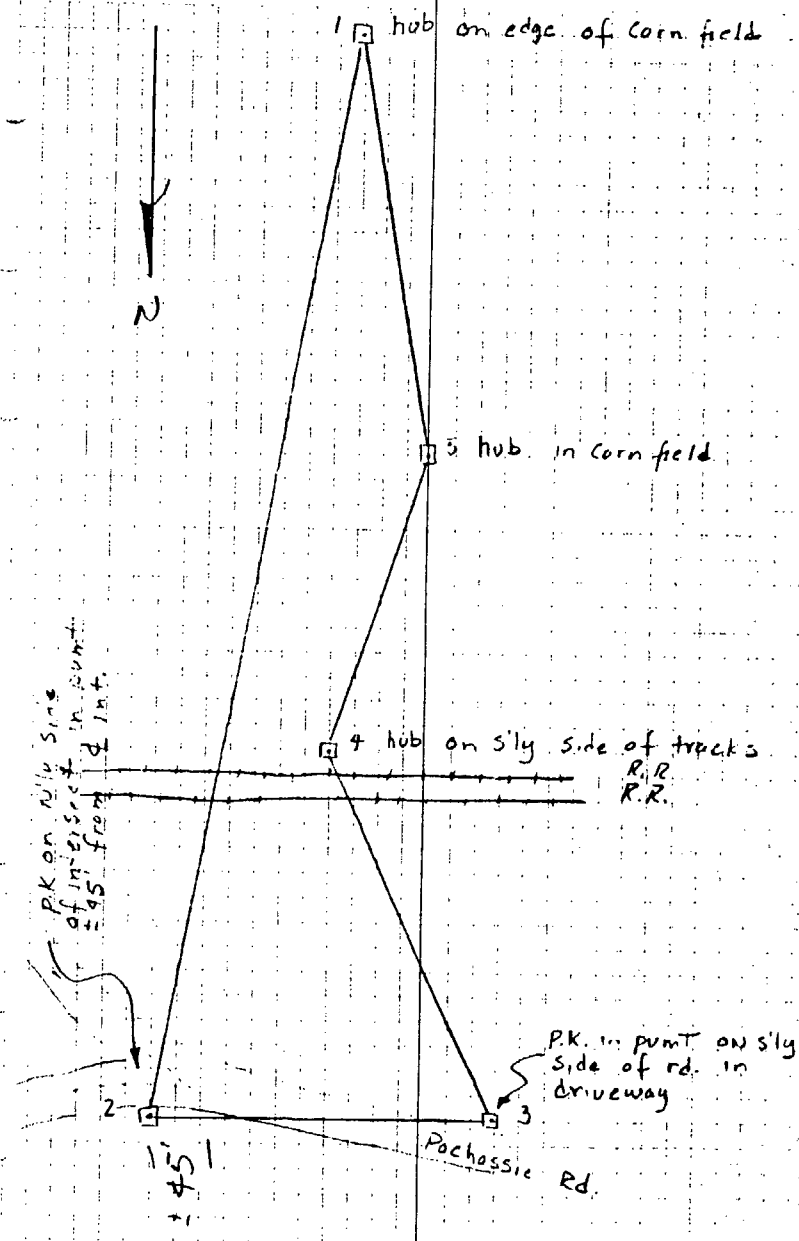



Station	Angle	Dist	R. d.
$\pi @ 1-0-51A$ $H.I. = \text{hub} \#1 + 4.85 = 162.31 + 4.85 = 167.16$			
4+00 <sup>31</sup>	272°15'	713'	7.12 160.04
6+00 <sup>32</sup>	258°05'	401'	7.58 159.58
8+00 <sup>33</sup>	252°56'	593'	7.03 158.13
43		-D-	-R- Elev.
$\pi @ 1A-0-1B$ $H.I. = \text{hub} \#1 + 3.40 = 162.31 + 3.40 = 165.71$			
2+00 <sup>34</sup>	123°26'	78'	4.49 161.22
S/A 1B <sup>35</sup>	0°	125'	5.70 160.01
0+00 <sup>35</sup>	349°04'	136'	9.66 155.85
6 7 8	264°49'54"		
1A-1B-1C	142°25'00"	289.78	92°34'24"
6 7	175°12'48"		
1-1A-1B	267°36'36"	125.05'	90°26'24"
6	255°03'24"		
5-1-1A	129°31'42"	175.49'	91°28'36"

DESIGN NO. 3844

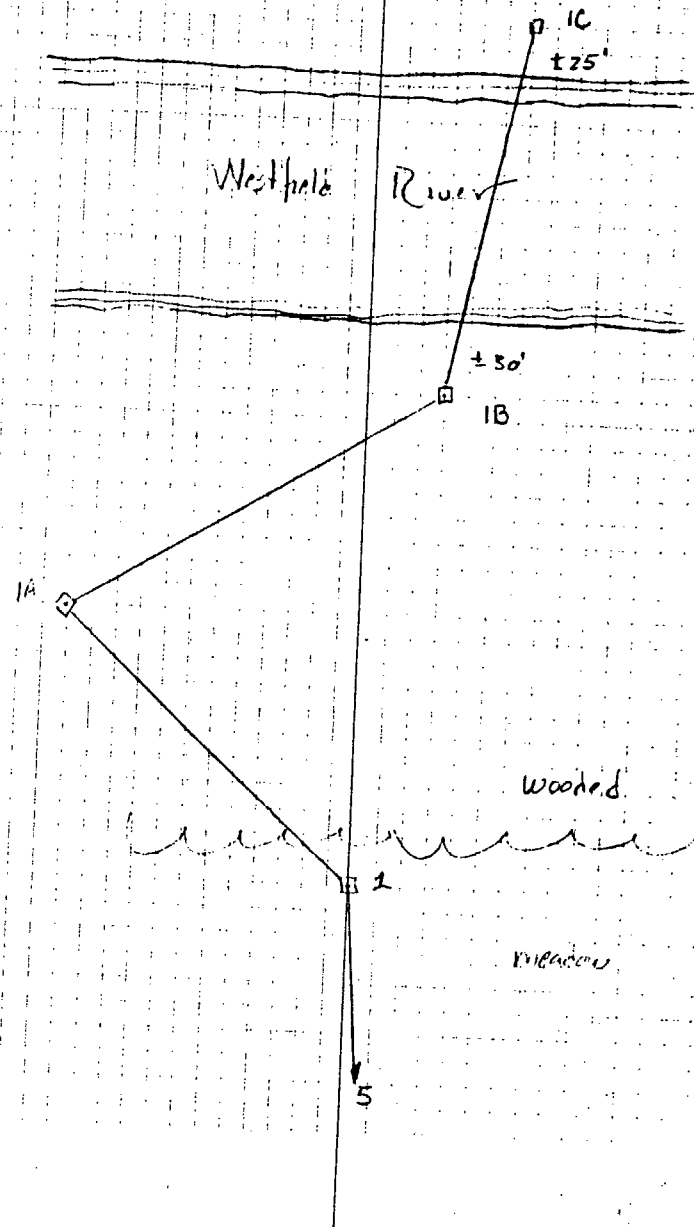

3	H <sub>A</sub>	-d-	-P-	
K@ 5-0-4				
Line C	H.I. = 4.22 + hub #5 = 4.22 + 159.82 =			✓ 159.04
STA 17+85	37° 28'	403'	2.90	156.14
STA 19+85	19° 05'	5.92'	5.0	154.04
STA 21+85	8° 39'	7.05'	4.60	154.44

Trig level across River  
 H.I. = hub #1B + 3.62 = 163.61  
 Vert A 88° 12' 46" @ T.P.  
 of hub  
Elev IC = 172.64

IB-IC-1A 12° 12' 36"  
 1° 06' 06"

4				
K@ 2A-0-E3				
H.I. = STA 2K + 5.41 = 195.22 + 5.41				
LINE XL				170.63 200.63
STA 4+00	11° 33'	45'	6.78	193.85
STA 3+00	33° 01'	92'	4.55	196.08

9				
K@ 2A-0-2				
H.I. = STA 2 + 3.72 = 195.72 + 3.72				
LINE XL				179.94
STA 2+00	353° 30'	4'	5.2	193.74
STA 1+00	171° 59'	95'	3.74	195.2
STA 0+00	169° 37'	195'	3.0	89° 198.14

LINE-1	Elev.	-D-	-R-	V A
STA 0+00	59° 12'	193.71	26'	5.23 193.71
STA 1+00	251° 24'	205.15	75'	5.0 21° 12' 13"
STA 2+00	251° 54'	221.99	175'	4.0 80° 59' 42"
STA 3+00	252° 10'	234.06	276'	5.0 21° 32' 42"
STA 4+00	252° 10'	248.19	374'	4.0 81° 43' 42"

3-2-2A 36° 39' 30"  
 18° 19' 36" 195.09' 91° 20' 30"

5		8	7		
		T@ 10-0-1B			
		HI = hub #1B + 4.08 = 172.64 + 4.08			
				= 176.72	
Line # 4	3	255'	7.18		
0+00	36	253°53'	255'	7.18	169.54
1+00	37	249°54'	155'	5.42	171.10
2+00	38	230°07'	59'	4.82	171.90
3+00	39	113°49'	58'	3.58	173.14
4+00	40	94°30'	154'	2.67	174.05

6					
		T@ 4-0-5			
		H.I. = RM + 4.77 = 163.81 + 4.89			
				= 168.70	
Line C	44	-D-	-R-	Elev.	
17+05	29	228'	14.31	154.39	
23+85	30	42'	15.45	153.25	
BM	64°48'	203'	4.89		
4	44	Elev.	-D-	-R-	V4
LINE 2	164°18'	234'	15.87		
STA 0+00	169°18'	152.81	234'	15.87	152.81
STA 1+00	162°19'	154.16	336'	19.54	154.16
STA 2+00	161°39'	164.65	432'	4.05	164.65
STA 3+00	157°59'	171.81	530'	6.0	89°00'54"
STA 4+00	157°59'	179.70	630'	3.0	88°43'36"
STA 1 on line 2 = 2500					
Line XL-2					
STA 0+00	127°38'	348'	10.82	157.88	
STA 1+00	149°35'	325'	12.75	155.95	
STA 3+00	177°32'	368'	14.39	154.31	
STA 4+00	189°20'	425'	13.28	155.42	

7					
STA	BS	ILI	FL	ELU.	
BM	4.08	167.89		163.81	
TP#1	0.63	158.68	9.84	158.05	
TP#2	13.29	169.64	2.33	156.35	
TP#3	12.29	180.705	1.225	168.415	
TP#4	14.65	194.765	0.59	180.115	
TP#5	5.81	199.96	0.615	194.15	
STA 2	0.845	196.065	4.74	175.22	✓
TP#6	0.825	<del>181.83</del> <del>211.75</del> 170.52	15.06	<del>211.125</del> 181.005	
TP#7	1.29	<del>200.64</del> 158.535	12.60	<del>179.35</del> 169.29	
TP#8	0.345	<del>167.965</del> 168.255	12.33	<del>166.31</del>	
TP#1	10.19	<del>177.685</del>	0.47	<del>187.495</del> 158.065	
BM			4.44	163.815	
	64.245		64.24		

U.S.G.S. Disk "H6"

Note:  
Line C

[ STA 15+85 - assume same elev.  
as STA 16+00 ]

Control pt #2 P.K. nail in rd.

Note:

[ Line 2, STA 1+00 = Line XL-2, STA 2 ]

8

STA	B.S.	H.I.	F.S.	Elev.
B.M.	5.715	169.525		163.81
Hub #4	4.04	167.715	5.85	163.675
T.P. #1	3.27	156.205	14.78	152.935
T.P. #2	5.165	157.555	3.215	152.39
Hub #5	5.22	160.035	2.74	154.815
T.P. #3	8.85	162.785	6.10	153.935
T.P. #4	5.255	165.23	2.81	159.975
T.P. #5	6.06	166.81	4.48	160.75
Hub #1	2.3.225	165.535	4.50	162.31
Hub #1 <sup>B</sup>	5.96	165.945	5.55	159.985
Hub #1	3.465	165.77	3.64	162.305
TP #6	1.55	162.47	4.85	160.92
8+00 L3			4.24	158.23
10+00 "			6.28	156.19
TP #7	4.07	161.98	4.56	157.91
12+00 L3			5.0	156.98
14+00 "			3.48	158.50
TP #8	3.525	163.515	1.99	159.99
16+00 L3			4.95	158.57
TP #9	3.38	159.845	7.65	156.465
TP #10	3.515	156.735	6.625	153.22
TP #1	14.96	167.855	3.84	152.815
B.M.			4.08	163.775
	87.225		97.26	

8

U.S.G.S. Disk "H6"

Control hub #4

Control hub #5

Control hub #1

Control hub #1B

Control hub #1

STA 8+00 Line 3

STA 10+00 Line 3

STA 12+00 Line 3

STA 14+00 Line 3

STA 16+00 Line 3

U.S.G.S. Disk "H6"

**SECTION 8**

**SEISMIC REFRACTION SURVEY REPORT**



# Weston Geophysical

CORPORATION

December 5, 1985  
WGC - R767

ATLANTIC TESTING LABORATORIES LTD.  
PO Box 29  
Canton, New York 13617

Gentlemen;

In accordance with the Army Corps of Engineers contract no. DACW33-85-D-0011, Weston Geophysical has performed a seismic refraction survey at Westfield, Massachusetts.

Preliminary profiles have previously been submitted to Atlantic Testing Laboratories, Ltd. This is a formal report of our findings.

Very truly yours,

WESTON GEOPHYSICAL CORPORATION

*M. Blackey*


Mark Blackey

MB:wpt-0233J1

SEISMIC REFRACTION SURVEY  
PROPOSED FLOOD CONTROL DAM  
WESTFIELD, MASSACHUSETTS

Prepared for  
ATLANTIC TESTING LABORATORIES, LTD.

DECEMBER, 1985

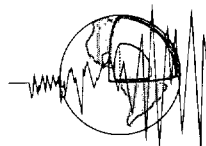

**Weston Geophysical**  
CORPORATION



## TABLE OF CONTENTS

	<u>Page</u>
LIST OF FIGURES	ii
1.0 INTRODUCTION & PURPOSE	1
2.0 LOCATIONING & SURVEY CONTROL	1
3.0 METHODS OF INVESTIGATION	1
4.0 PRESENTATION OF RESULTS	1
5.0 MATERIAL IDENTIFICATION	2
5.1 Overburden	2
5.2 Bedrock	3
6.0 DISCUSSION OF RESULTS	3
FIGURES	
APPENDIX	
A Seismic Refraction Survey Method of Investigation	

LIST OF FIGURES

- FIGURE 1      Seismic Exploration and Survey Map  
FIGURE 2      Seismic Profiles

## 1.0 INTRODUCTION & PURPOSE

A seismic refraction survey was conducted for Atlantic Testing Laboratories, Ltd. at a proposed flood control dam in Westfield Massachusetts. The survey was conducted during the period of November 12 through 15, 1985.

The purpose of this study was to determine the thickness and seismic velocities of the various layers present and to determine the depth to bedrock.

All fieldwork was coordinated through Atlantic Testing of Canton, New York.

## 2.0 LOCATIONING & SURVEY CONTROL

The area of investigation is shown on the location map included in Figure 1. This map is a segment of the Westfield, Massachusetts United States Geological Survey Topographic Quadrangle Map. The specific lines of coverage are also shown on Figure 2. Vertical and horizontal control was provided by Atlantic Testing.

## 3.0 METHOD OF INVESTIGATION

The field program consisted of continuous seismic refraction profiling. Seismic spread lengths of 400 and 800 feet were used, depending upon site characteristics. A discussion of the seismic refraction profiling technique is included as Appendix A to this report.

## 4.0 PRESENTATION OF RESULTS

The results of this survey are presented in tabular form in Figure 1, and as a series of seismic profiles on Figure 2. These profiles show thickness of the various seismic layers and their seismic velocity values.

## 5.0 MATERIAL IDENTIFICATION

Using seismic data alone, materials can be placed into broad classifications based on the velocity of the seismic wave transmitted through them. Each velocity value does not correlate uniquely with a specific material, but most bedrock as well as overburden types fall within the restricted velocity ranges given below.

### 5.1 Overburden

The velocity range of a few hundred to less than 1,000 ft/sec is typical for very loose fill materials.

The velocity range of 1,000 to 2,000 ft/sec is indicative of loose, unconsolidated, and unsaturated materials. In the New England area, these materials are often fluvial deposits.

The velocity range of 2,000 to 3,000 ft/sec is usually indicative of an unsaturated overburden material, possibly a coarse gravel or ground moraine type of glacial till.

Seismic velocity values in the range of 3,000 to 4,500 ft/sec are usually representative of a compact type of overburden material such as a relatively dense glacial till.

Seismic velocity values of 4,800 to 5,300 ft/sec are typical for water-saturated fluvial deposits. This velocity range is characteristic of materials which have been developed successfully as municipal groundwater supplies.

The velocity range of 6,000 to 8,000 ft/sec is usually characteristic of dense glacial till.

## 5.2 Bedrock

Depending upon the degree of weathering, bedrock can have seismic velocity values spanning virtually the entire range of values for overburden; at the lower end of this range, however, the bedrock will have the physical characteristics of overburden.

Seismic velocities in the range of 8,000 to 10,000 ft/sec are commonly indicative of slightly to moderately weathered bedrock which may require at least localized drilling and blasting for excavation.

The velocity range of 12,000 to 12,500 ft/sec at this site is indicative of bedrock which is generally sound and unweathered, and will require systematic drilling and blasting for excavation.



## 6.0 DISCUSSION OF RESULTS

Bedrock depths up to 80 feet were found along Line 3, on the floodplain of the Westfield River. Shallow rock was observed on the remaining seismic spreads; depths to rock are as shallow as five feet on the left abutment.








Densely packed gravel at Line 4 resulted in shallow shot holes, necessitating reduction of the explosive charges. Thus, seismic data acquired along Line 4 exhibited lower-energy arrivals, and depths calculated from these data have some uncertainty. Accordingly, the Line 4 profiles are dashed.

FIGURES

STATION	COORDS. NORTH	COORDS. EAST	ELEV. (MSL)	DEPTH TO BEDROCK
1	8766	8174	162.5	
2	10,723	10,723	154.8	
3	10,000	10,000	154.8	
4	10,723	10,723	154.8	
5	10,723	10,723	154.8	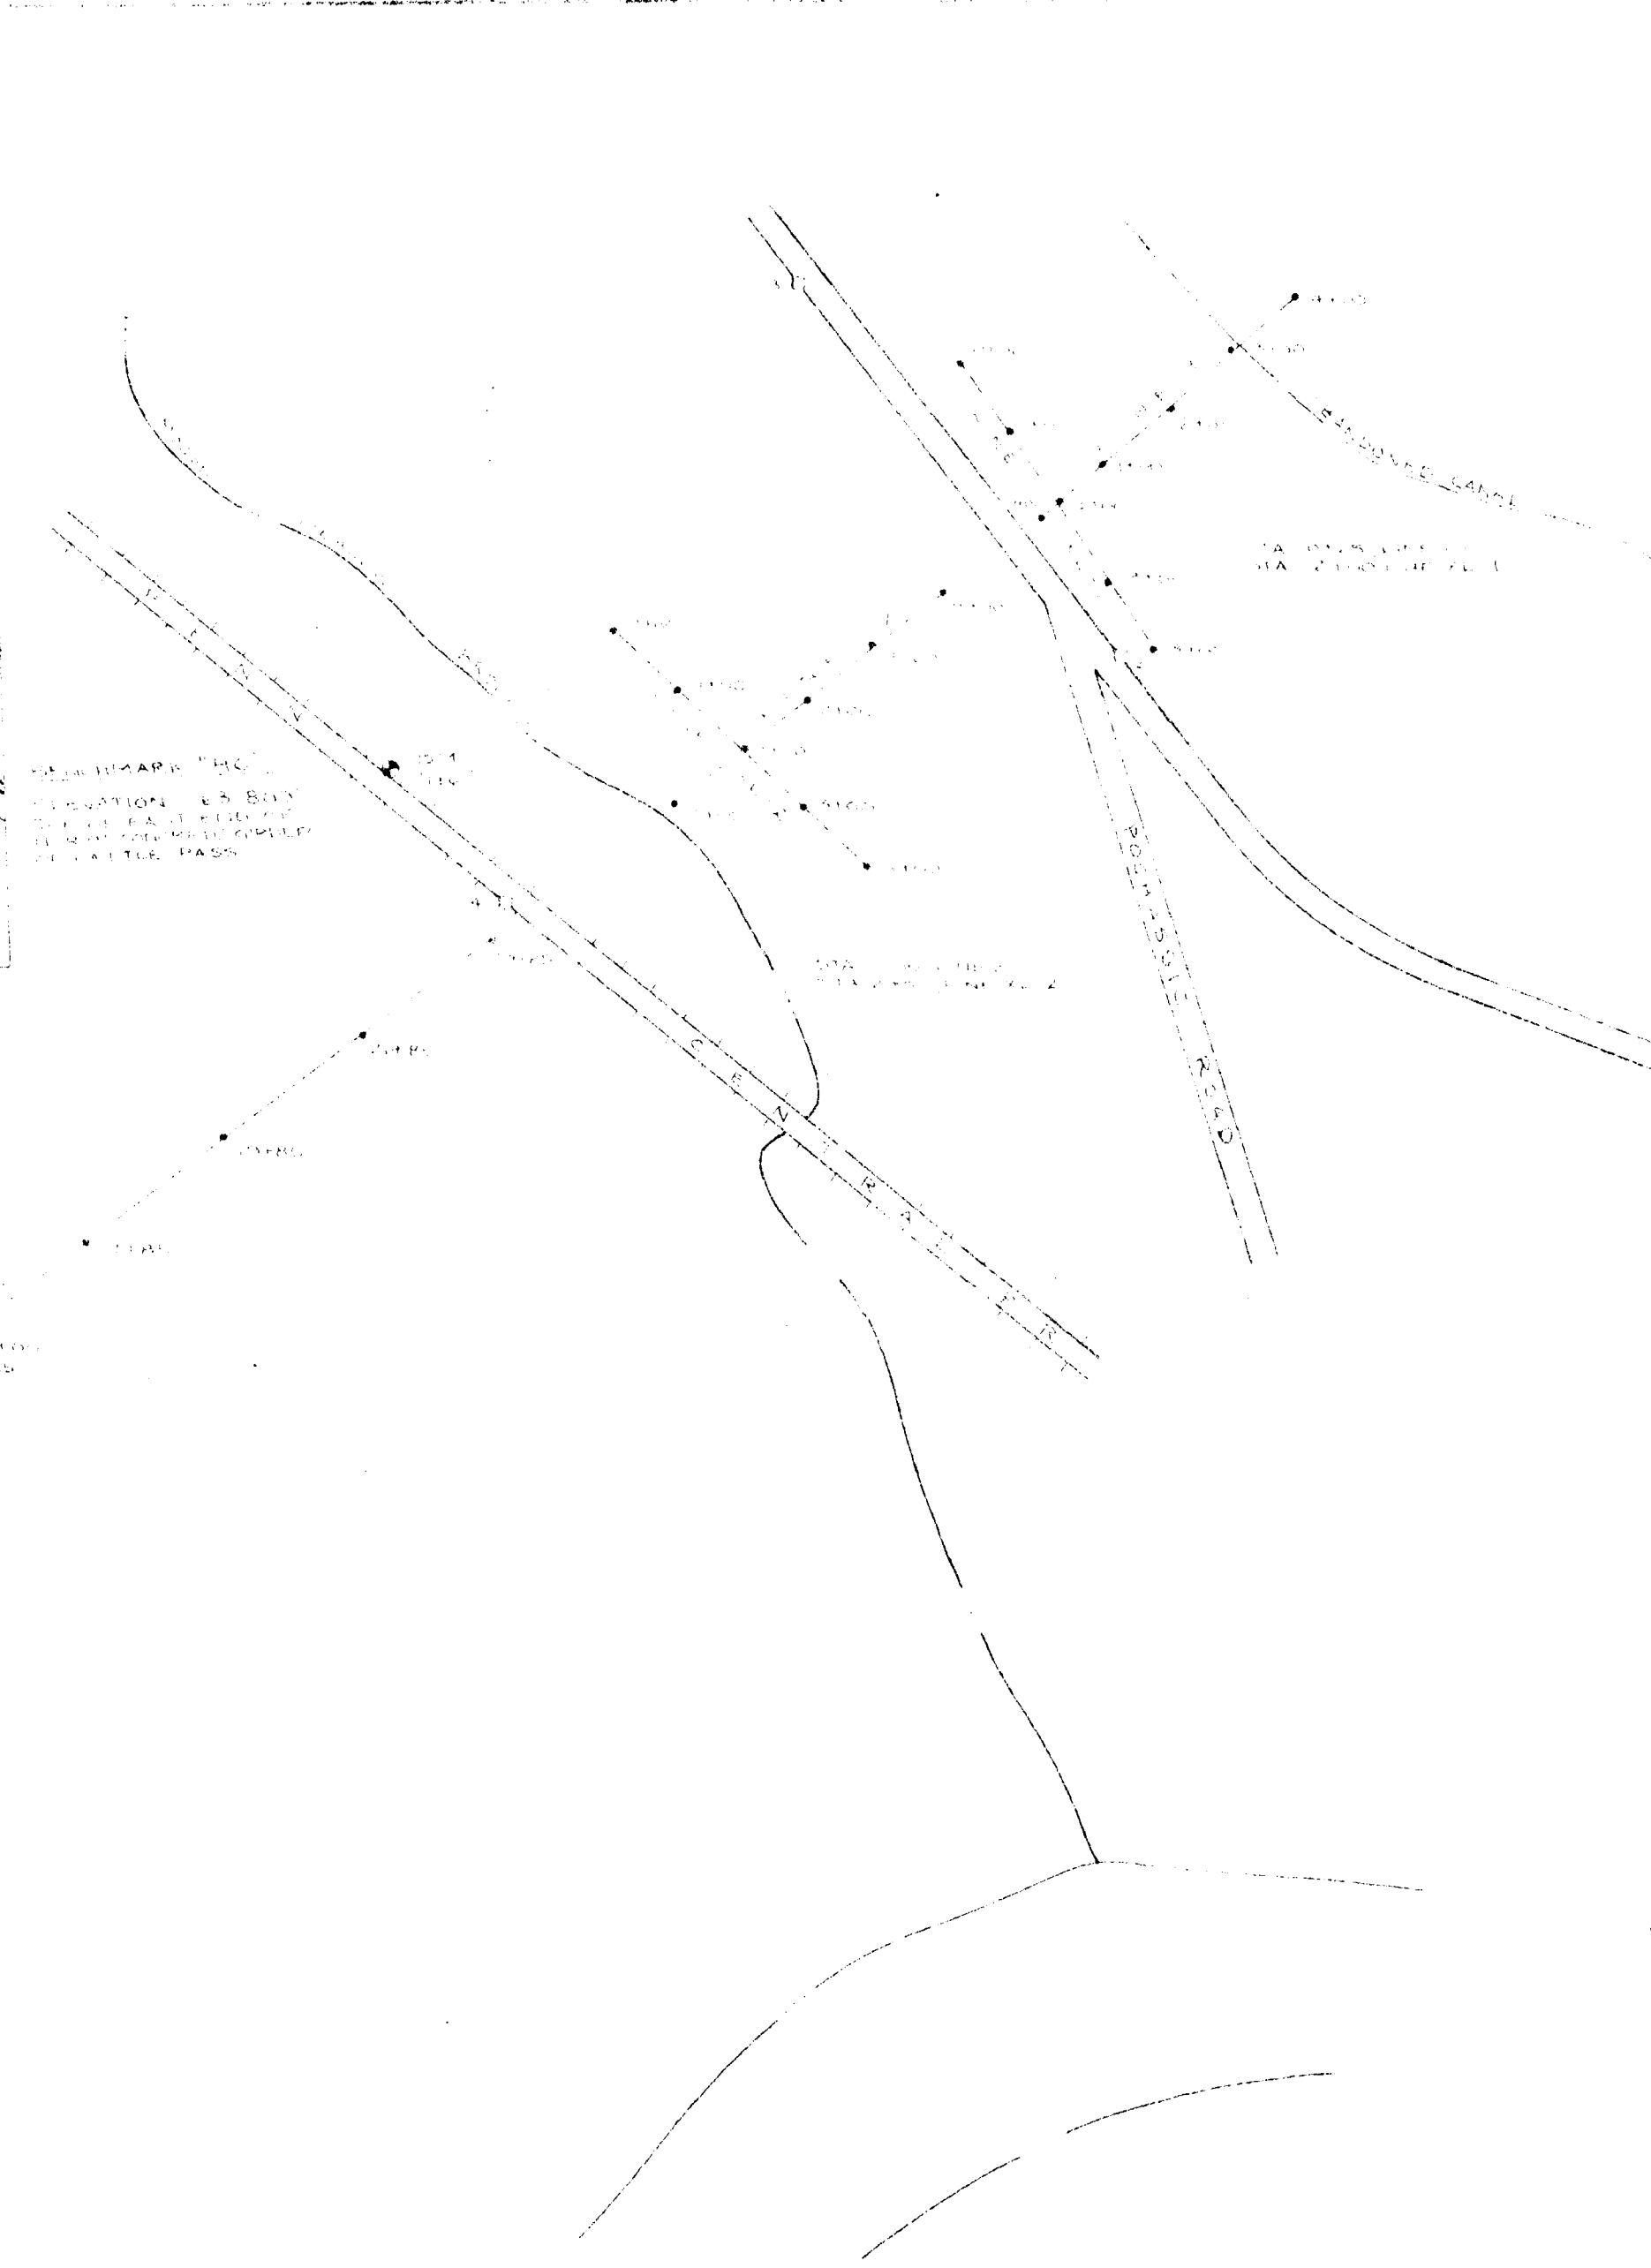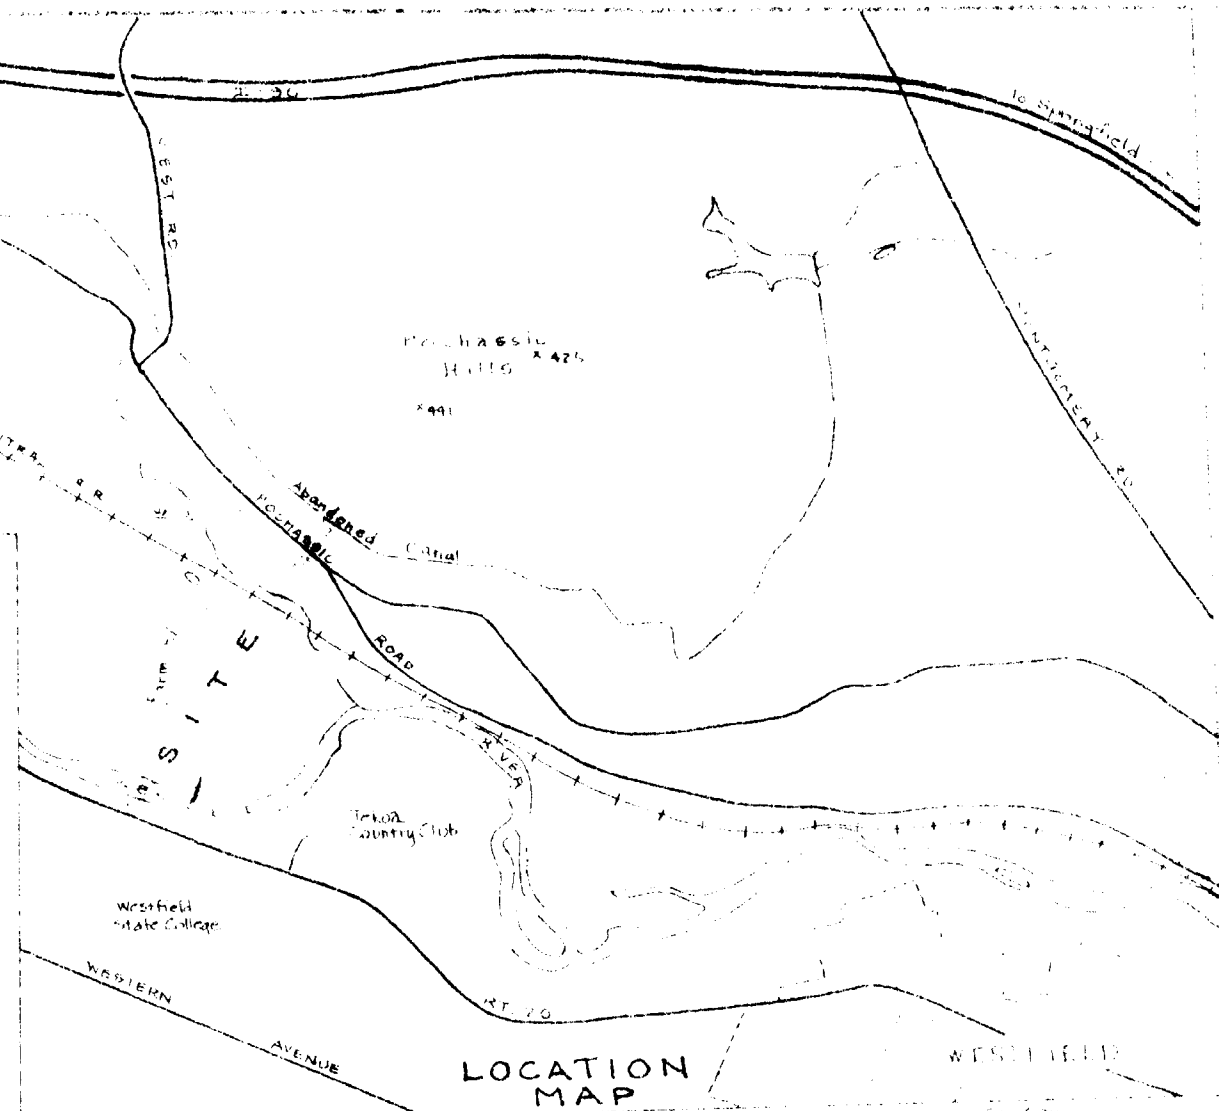
SLA	SEISMIC EXPLORATION AND SURVEY MAP
DATE	WESTFIELD RIVER
SCALE	WESTFIELD, MASS.
1" = 200'	SPENCER E. THEW, P.E./L.S.
DATE	NOVEMBER 1985
NOV 26, 1985	WESTON GEOPHYSICAL CORPORATION
CD-007	DECEMBER 1985

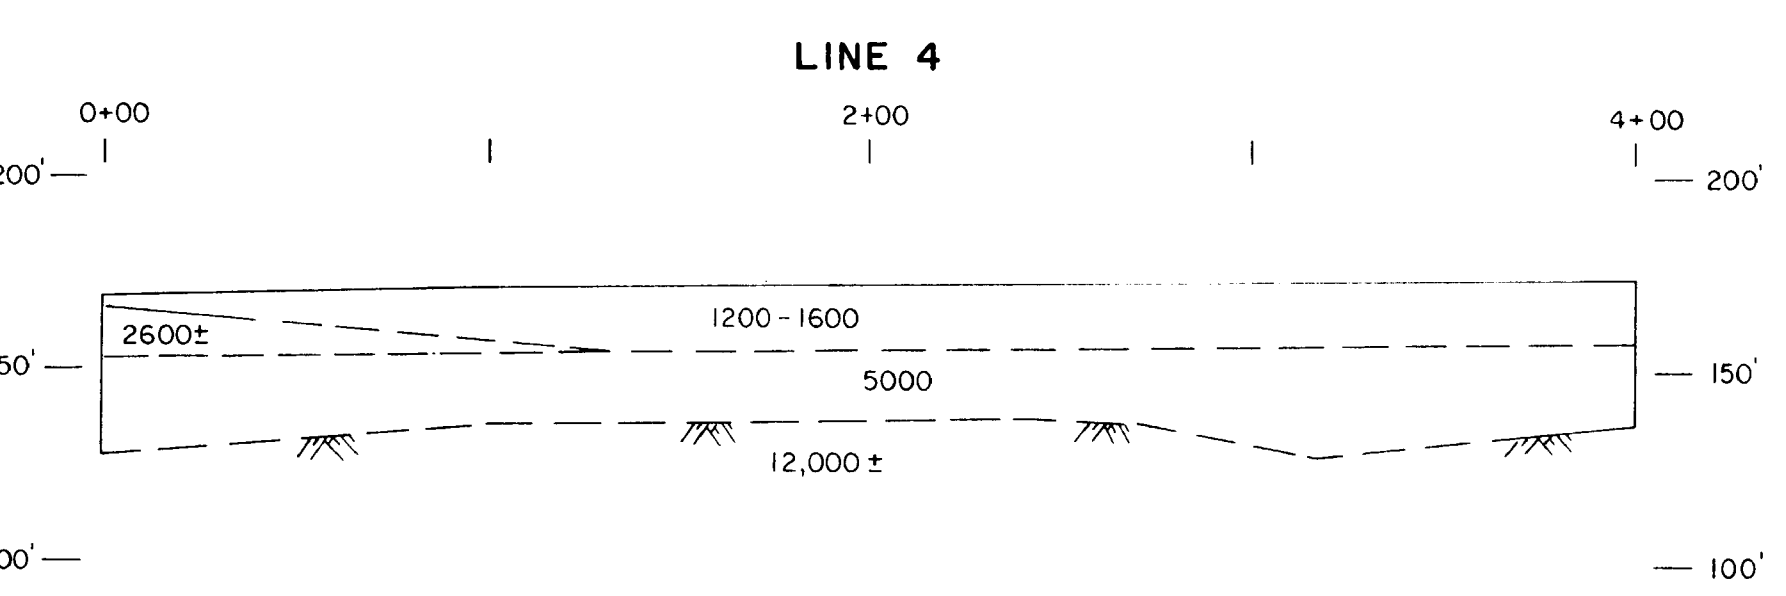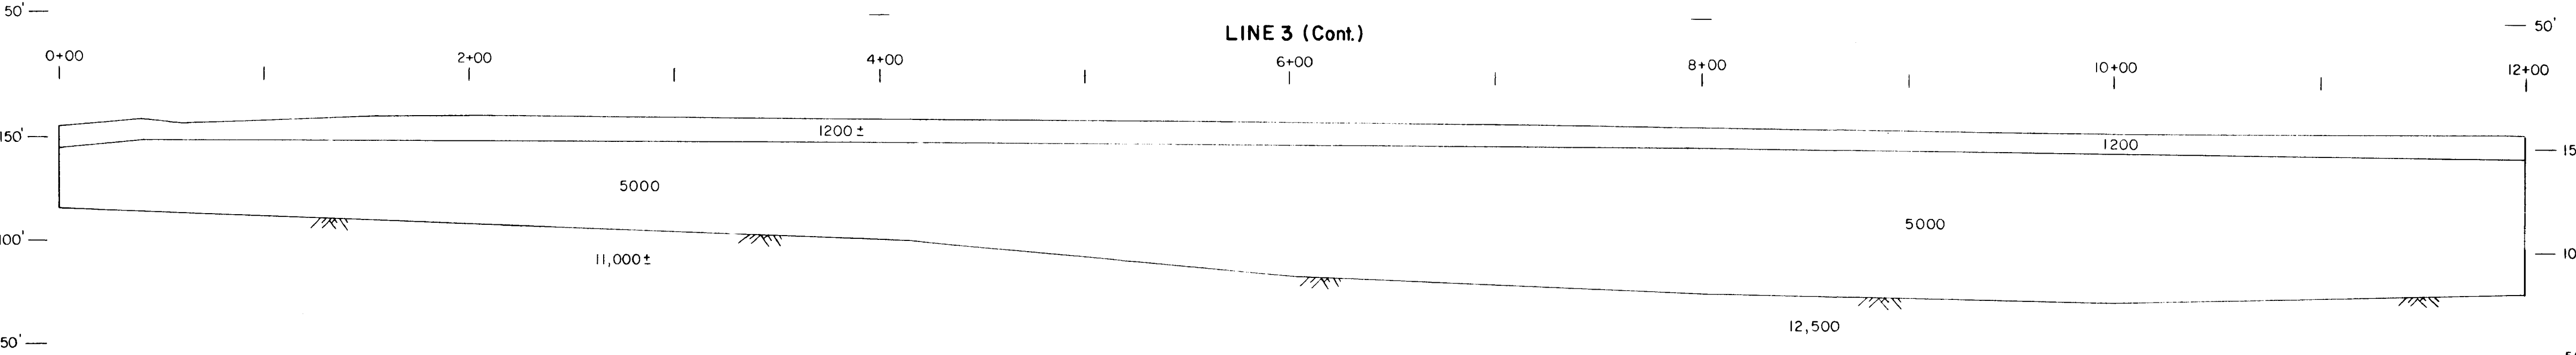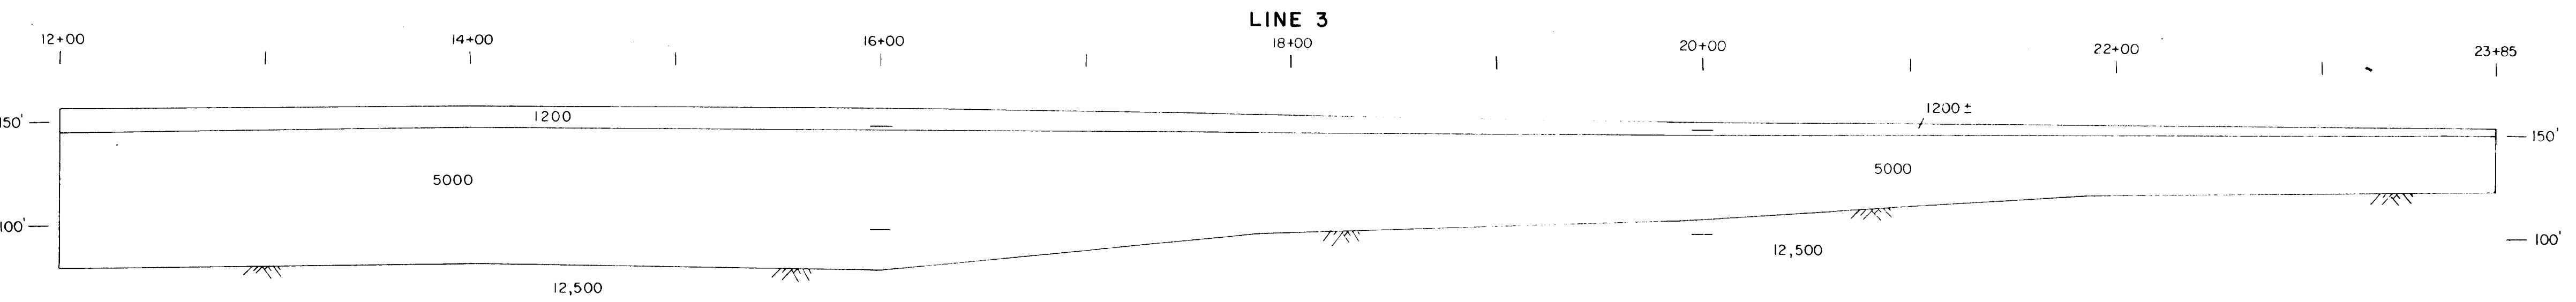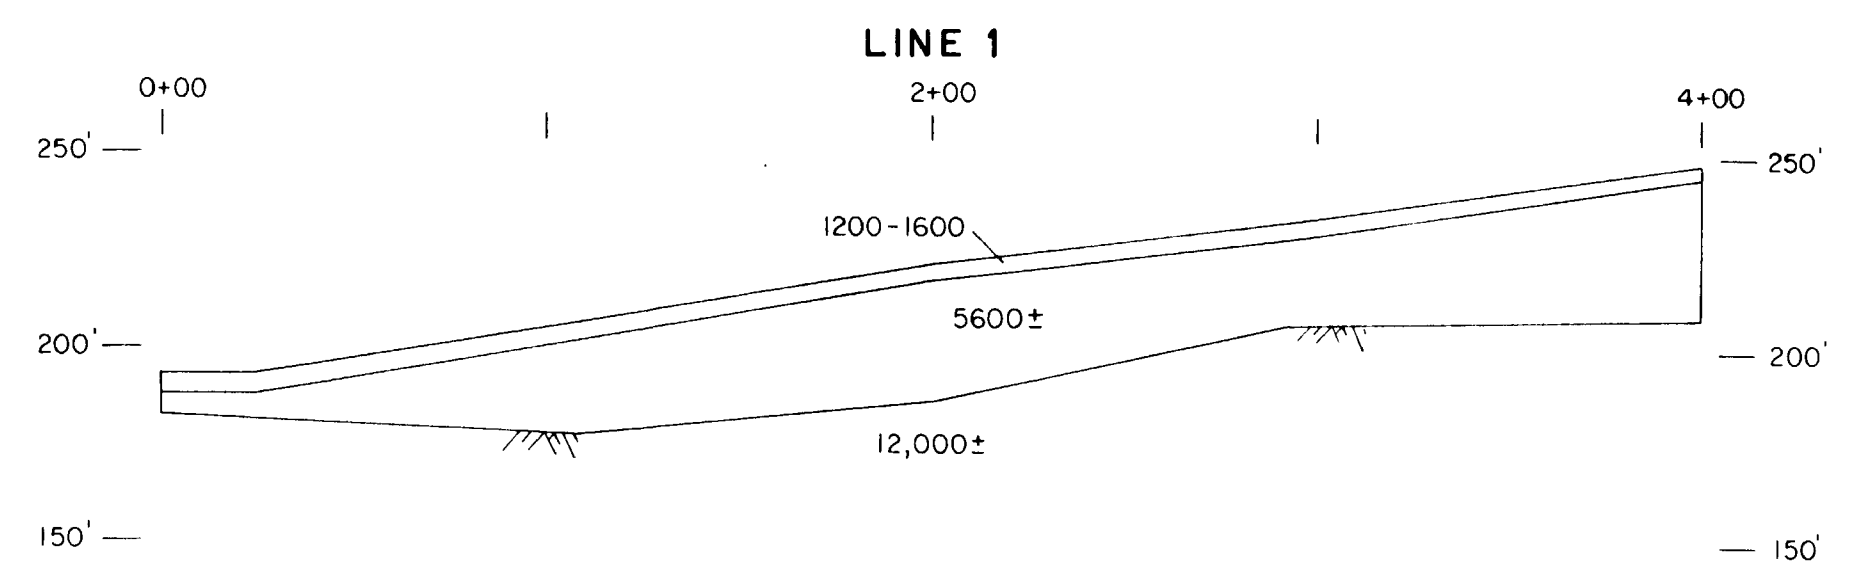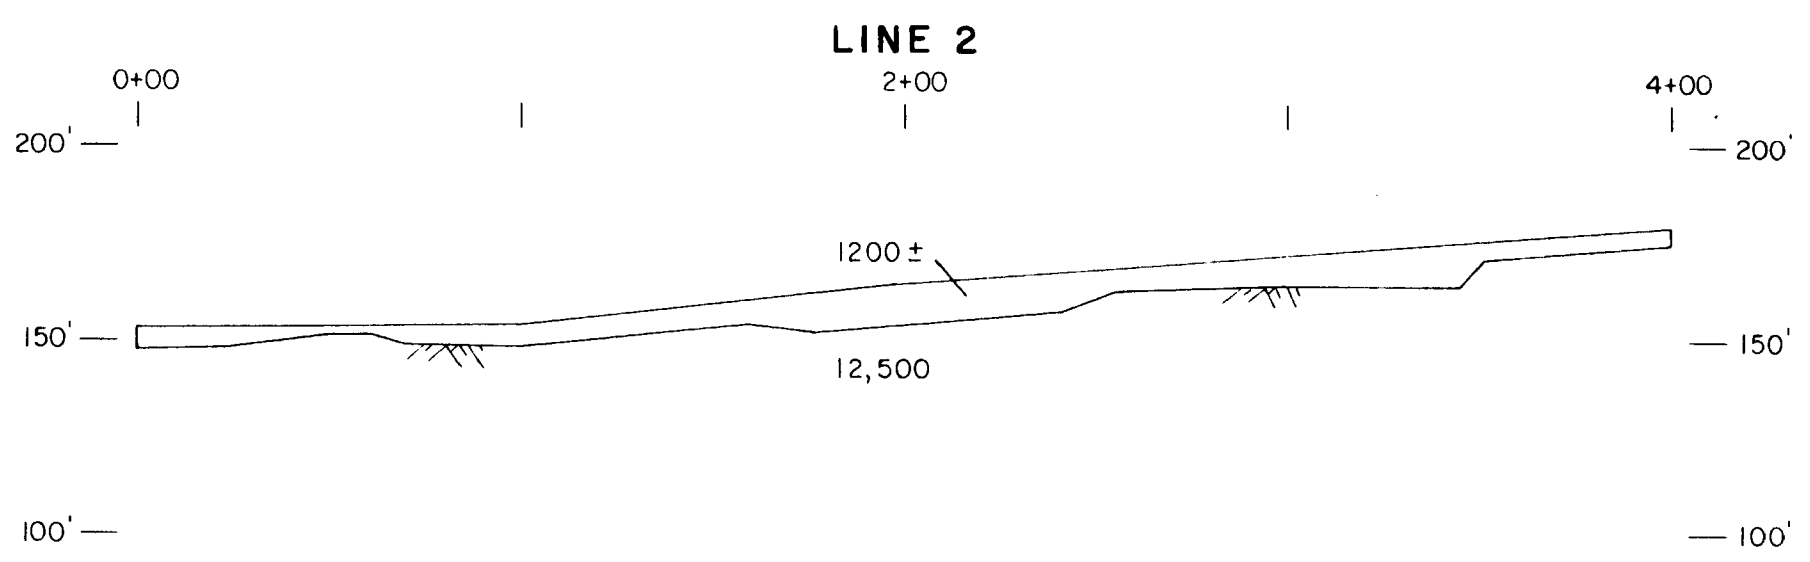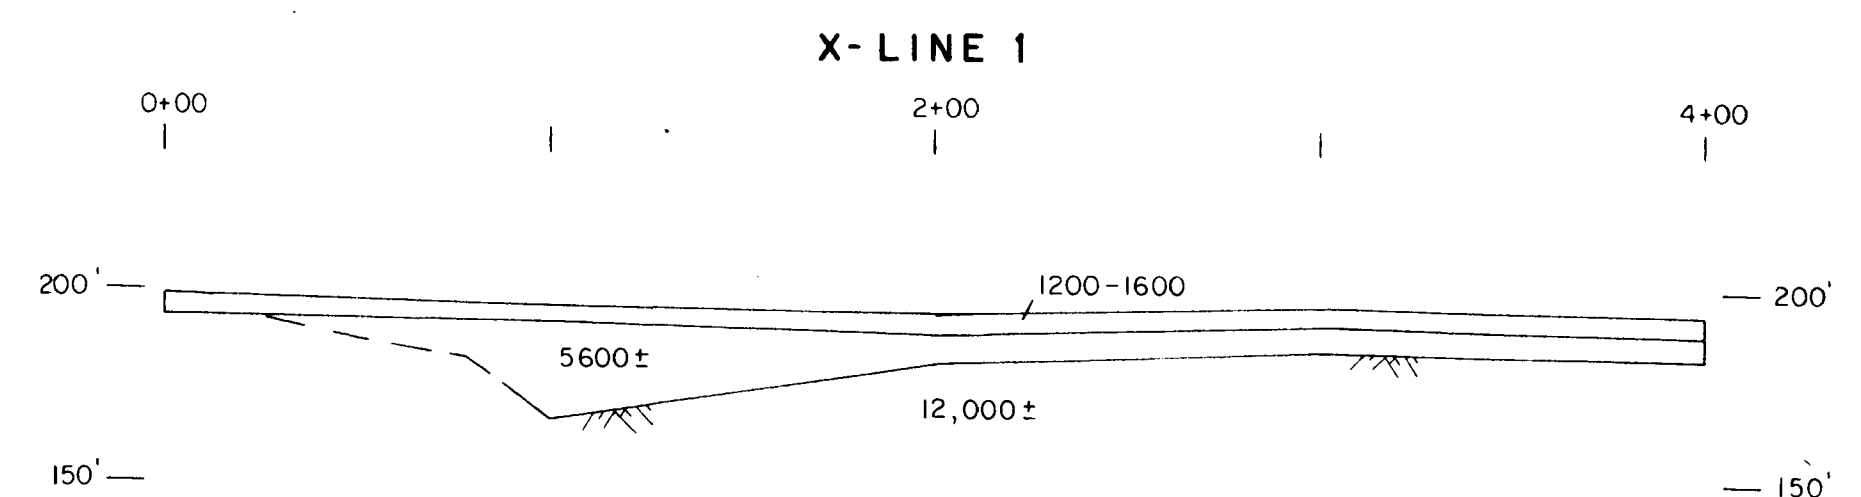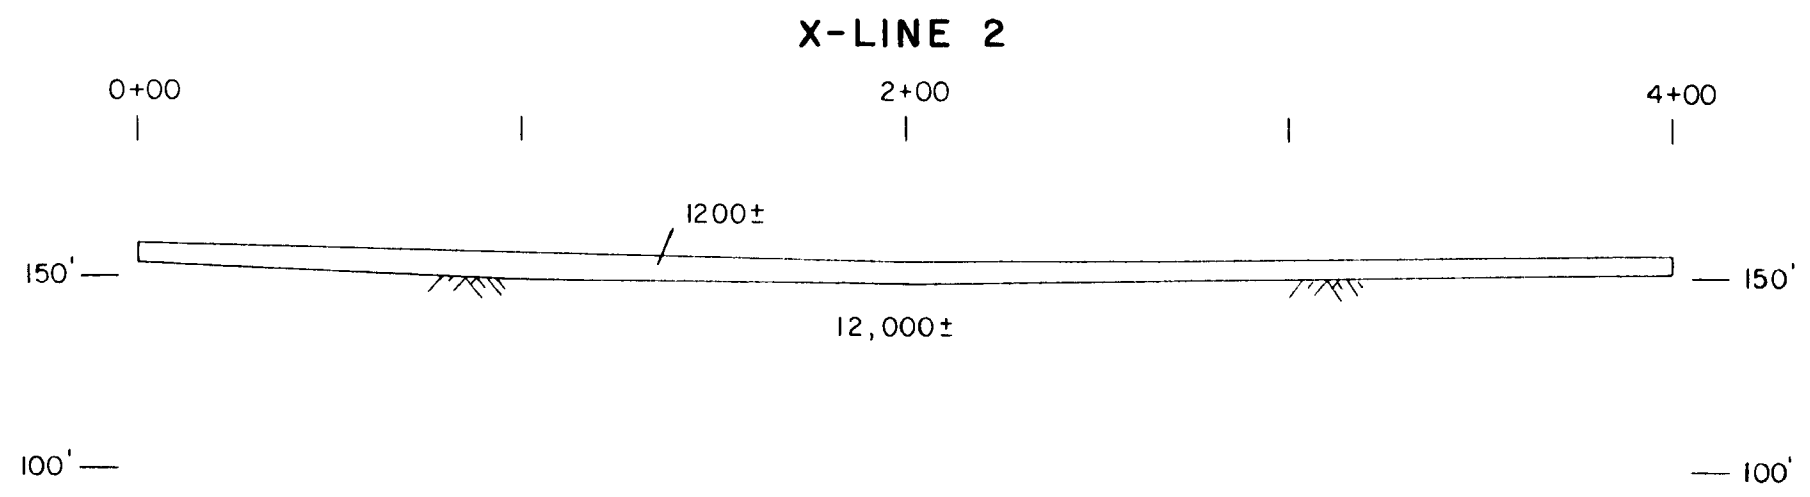

0 50 100 FT.

NOTE: SEISMIC VELOCITIES SHOWN ARE  
IN FEET/SECOND.



**APPENDIX A**  
**SEISMIC REFRACTION SURVEY**  
**METHOD OF INVESTIGATION**

## GENERAL CONSIDERATIONS

The seismic refraction survey method is a means of determining the depths to a refracting horizon and the thickness of major seismic discontinuities overlying the high-velocity refracting horizon. The seismic velocities measured by this technique can be used to calculate the mechanical properties of subsurface materials [moduli values], as well as for material identification and stratigraphic correlation.

Interpretations are made from travel time curves showing the measurement of the time required for a compressional seismic wave to travel from the source ["shot"] point to each of a group of vibration sensitive devices [seismometers or geophones]. The geophones are located at known intervals along the ground surface, as shown in Diagram A. Various seismic sources may be used, including a drop weight, an air gun, and small explosive charges.

## FIELD PROCEDURE FOR DATA ACQUISITION

Weston Geophysical Corporation uses a seismic recording technique of continuous profiling and overlapping spreads for engineering and ground water investigations. The seismic refraction equipment consists of a Weston Geophysical trace amplifier, Model USA780, with either a WesComp 11™ [a field computer system developed by Weston], or a recording oscillograph.

Continuous profiling is accomplished by having the end shot-point of one spread coincident with the end or intermediate position shot-point of the succeeding spread. The spread length used in a refraction survey is determined by the required depth of penetration to the refracting horizon. It is generally possible to obtain adequate penetration when the depth to the refracting horizon is approximately one-third to one-quarter of the spread length.

In general, "shots" are located at each end and at the center of the seismic spread, Diagram B. The configuration of the geophone array and the shot point positions are dependent upon the objectives of the seismic array.

As mentioned above, seismic energy can be generated by one or more of several sources.

The seismometer or geophone is in direct contact with the earth and converts the earth motion resulting from the shot energy into electric signals; a moving coil electromagnetic geophone is generally used. This type of detector consists of a magnet permanently attached to a spiked base which can be rigidly fixed to the earth's surface. Suspended within the magnet is a coil wrapped mass. Relative motion between the magnet and coil produces an electric current, with a voltage proportional to the particle velocity of the ground motion.

The electric current is carried by cable to the recording device which provides simultaneous monitoring of each of the individual geophones. The operator can amplify and filter the seismic signals to minimize background interference. For each shot the seismic signals detected by a series of geophones are recorded on either photographic paper or magnetic tape, depending on job requirements. Included on each shot record is a "time break" representing the instant at which the shot was detonated.

#### INTERPRETATION THEORY


The elastic wave measured in the seismic refraction method, the "P" or compressional wave, is the first arrival of energy from the source at the detector. This elastic wave travels from the energy source in a path causing adjacent solid particles to oscillate in the direction of wave propagation. Diagram A shows a hypothetical subsurface consisting of a lower velocity material above a higher velocity material. At smaller distances between source and detector the first arriving waves will be direct waves that travel near the ground surface through the lower velocity material. At greater distance, the first arrival at the detector will be a refracted wave that has taken an indirect path through the two layers. The refracted wave will arrive before the direct wave at a greater distance along the spread because the time gained in travel through the higher-speed material compensates for the longer path. Depth computations are

based on the ratio of the layer velocities and the horizontal distance from the energy source to the point at which the refracted wave overtakes the direct wave.

Generally the interpretation is by one or more of several methods [W.M. Telford, et al, 1976] ray-tracing, wave front methods, delay times, critical distances, etc. In addition, either a forward or inverse interpretation can be performed using Weston's computer. Since successful refraction interpretation is based on experience, all interpretation of refraction data is performed or thoroughly reviewed by a senior staff geophysicist.

#### Reference


Telford, W.M.; Geldart, L.P.; Sheriff, R.E. and Keys, D.A., 1976, Applied Geophysics: Cambridge University Press.

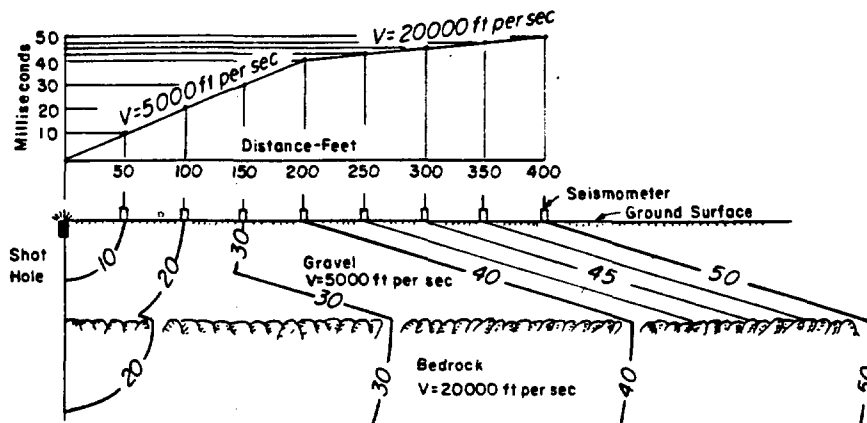

Plot of Wave Front Advance in Two Layered Problem

Linehan, Daniel, Seismology Applied to Shallow Zone Research, Symposium on Surface and Subsurface Reconnaissance, Special Technical Publication No. 122, American Society for Testing Materials, 1951.

Diagram A

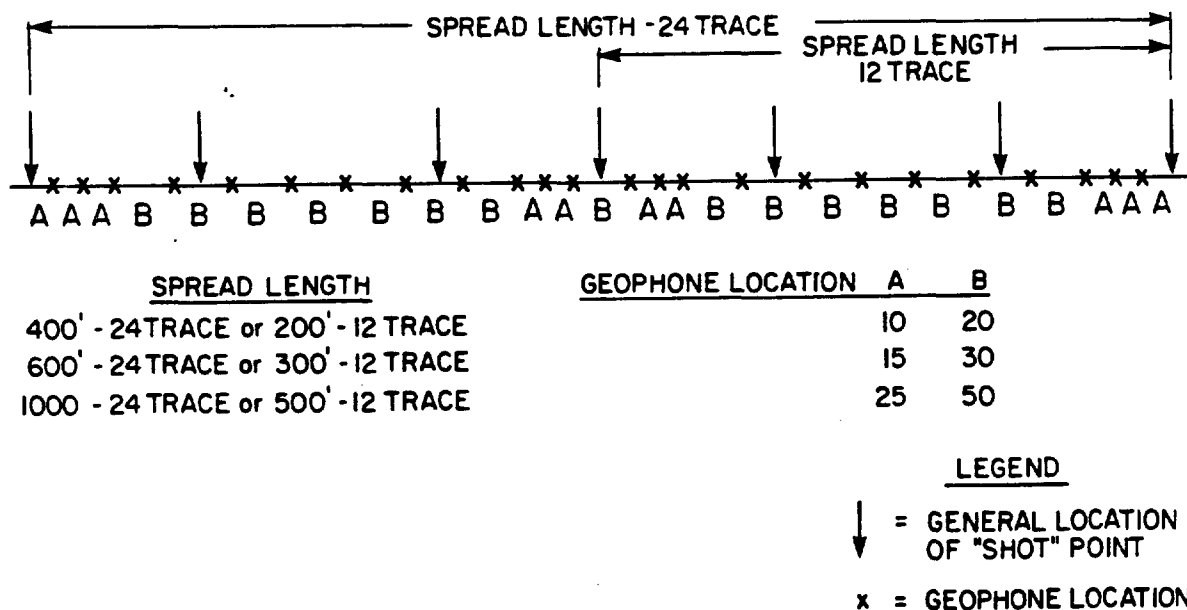

Geophone Interval-Spread Length Relationship

Diagram B